

JEFFERSON COUNTY DEPARTMENT OF HEALTH AND ENVIRONMENT
260 S. KIPLING, LAKEWOOD, CO 80226 PHONE: 239-7075

INDIVIDUAL SEWAGE DISPOSAL SYSTEM PERMIT NO. 13009

Site Address: 13670 HWY 285

Issued to: KILLEN

Legal Description: P/NW/4, SE/4 + P/SW/4, NE/4 - S7-T7S-R71W

System Designed for a 5 Bedroom Single Family Dwelling

Tank Size: 1500 gal. (min)


Absorption Bed Size: 1185 sq. ft. (min)

FINAL APPROVAL BY
INSPECTOR: MIKE DAVIS

FINAL
APPROVAL DATE: 12/12/88

SYSTEM AS INSTALLED

NORTH

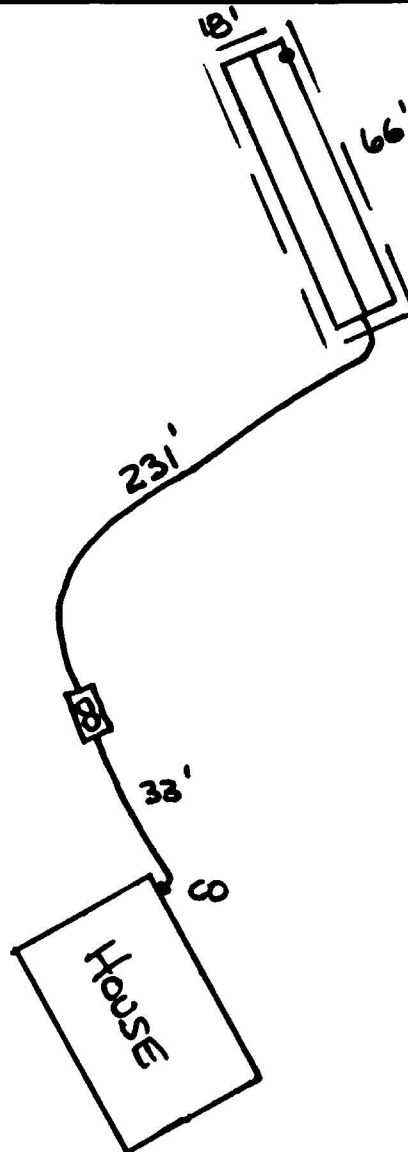

⊙ WELL